

)TES	Sprint 🎾
AILS	CC CROWN CASTLE 200 Spectrum Center Drive, Suite 1700 Irvine, California 92618
	FXX8 PREVAUEDT: Jeffrey Rome ASSOCIATES architecture telecommunications 131 Innovation Drive; Suite 100 Irvine, California 92617 tel 949.760.3929 fax 949.760.3931
сом	REVISIONS REV. DATE DESCRIPTION INIT. 1 08/16/17 90% CD REVIEW MS 2 08/28/17 100% FINAL CD'S MS 3 09/06/17 CLIENT COMMENTS BV
JITE 1700	4 12/13/17 PC COMMENTS MS 5 NOT FOR CONSTRUCTION UNLESS LABELED AS CONSTRUCTION SET
of Ventura rector Hearing . PL20-0055 - Site Plans	EFFREYL ROVE CO20376 EV. 2.2.9.19 PORTOF CALLEDING
	SITE INFORMATION: VR03XC049 CROWN SITE: 881022 PITAS POINT 3945 PACIFIC COAST HIGHWAY VENTURA, CALIFORNIA 93002 VENTURA, COUNTY
THIS SET REPRESENT THE CORRECT SCALE ONLY TED IN A 11"X17" OR 22"X34" FORMAT. IF THIS 22"X34", THIS SET IS NOT TO SCALE.	SHEET TITLE:
LE	TITLE SHEET

SITE PLAN GENERAL NOTES

SETBACKS: FRONT YARD = TBD BACK YARD = TBD SIDE YARDS = TBD

1. SITE CONTRACTOR TO CALL DIG ALERT (1-800-227-2600) TO LOCATE ANY AND ALL UNDERGROUND UTILITIES PRIOR TO ANY EXCAVATION.


- 2. ALL FACILITIES TO BE INSTALLED ARE UNMANNED. NO EXISTING PARKING SPACES WILL BE IMPACTED BY THE NEW USE.
- 3. PRIOR TO THE ISSUANCE OF ANY CONSTRUCTION PERMITS, THE APPLICANT SHALL INCORPORATE ANY CONSTRUCTION BEST MANAGEMENT PRACTICES NECESSARY.
- 4. PRIOR TO THE ISSUANCE OF ANY CONSTRUCTION PERMITS, THE APPLICANT SHALL SUBMIT A WATER POLLUTION CONTROL PLAN (WPCP). THE WPCP SHALL BE PREPARED IN ACCORDANCE WITH THE CITY'S STORM WATER STANDARDS.


STORM WATER QUALITY NOTES CONSTRUCTION BMP'S


THIS PROJECT SHALL COMPLY WITH ALL REQUIREMENTS OF THE STATE OF CALIFORNIA REGIONAL WATER QUALITY CONTROL BOARD.

NOTES 1-6 BELOW REPRESENT KEY MINIMUM REQUIREMENTS FOR CONSTRUCTION BMP'S.

- SUFFICIENT BMPS TO BE DEPLOYED, I.E. GRAVEL BAGS, DRY CLEANUP METHODS, COVERED STORAGE, ETCMUST BE INSTALLED TO PREVENT SILT, MUD OR OTHER CONSTRUCTION DEBRIS FROM BEING TRACKED INTO THE DAJACENT STREET(S) OR STORM WATER CONVEYANCE SYSTEMS DUE TO CONSTRUCTION VEHICLES OR ANY OTHER CONSTRUCTION ACTIVITY. THE CONTRACTOR SHALL BE RESPONSIBLE FOR CLEANING ANY SUCH DEBRIS THAT MAY BE IN THE STREET AT THE END OF EACH WORK DAY OR AFTER A STORM EVENT THAT CAUSES A BREECH IN THE INSTALLED CONSTRUCTION BMEN. INSTALLED CONSTRUCTION BMPS.
- ALL STOCK PILES OF UNCOMPACTED SOIL AND/OR BUILDING MATERIALS THAT ARE INTENDED TO BE LEFT UNPROTECTED FOR A PERIOD GREATER THAN SEVEN CALENDAR DAYS ARE TO BE PROVIDED WITH EROSION AND SEDIMENT CONTROLS. SUCH SOIL MUST BE PROTECTED EACH DAY WHEN THE PROBABILITY OF RAIN IS %40 OR GREATER.
- A CONCRETE WASHOUT SHALL BE PROVIDED ON ALL PROJECTS WHICH PROPOSE THE CONSTRUCTION OF ANY CONCRETE IMPROVEMENTS THAT ARE TO BE POURED IN PLACE ON THE SITE.
- ALL EROSION/SEDIMENT CONTROL DEVICES SHALL BE MAINTAINED IN WORKING ORDER AT ALL TIMES.
- ALL SLOPES THAT ARE CREATED OR DISTURBED BY CONSTRUCTION ACTIVITY MUST BE PROTECTED AGAINST EROSION AND SEDIMENT TRANSPORT AT ALL TIMES.
- THE STORAGE OF ALL CONSTRUCTION MATERIALS AND EQUIPMENT MUST BE PROTECTED AGAINST ANY POTENTIAL RELEASE OF POLLUTANTS INTO THE ENVIRONMENT.

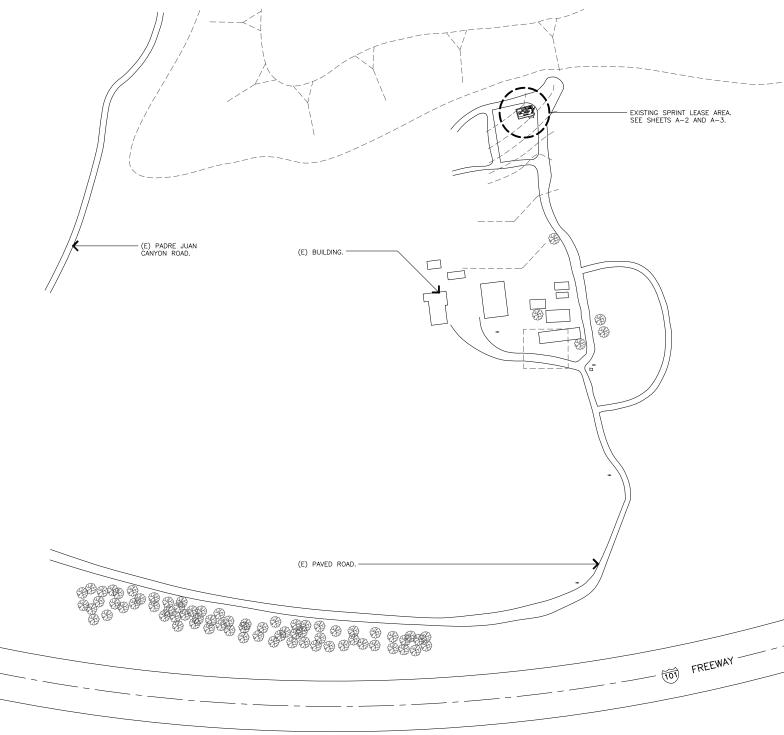

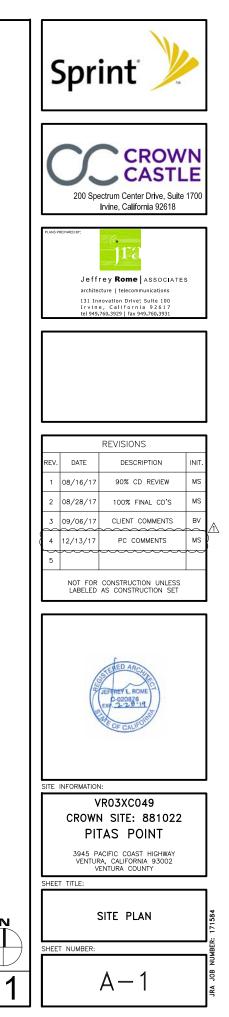

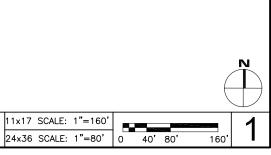

GENERAL	GUIDELINES	PAINTING NOTES & SPECIFICATIONS	STRUCTURAL SP	ECIFICATIONS
1. THE LATEST EDITION OF THE AMERICAN INSTITUTE OF ARCHITECTS DOCUMENT	20. THE CONTRACTOR SHALL PROVIDE TEMPORARY WATER, POWER AND TOILET FACILITIES AS REQUIRED BY THE PROPERTY OWNER.	A. GENERAL	A. GENERAL	 MIXING: PREPARATION OF CONCRETE C-94. NO MORE THAN 90 MINUTES
2. THIS FACILITY IS AN UNOCCOFIED FCS TELECOMMUNICATIONS SHE AND IS	CODINT AND THE OTHER OF COMERNING ACENOV	 ALL PAINT PRODUCT LINES SHALL BE SHERWIN WILLIAMS UNLESS SPECIFICALLY NOTED OTHERWISE. 	PRECEDENCE: UNLESS OTHERWISE SHOWN OR SPECIFIED, THE FOLLOWING GENERAL NOTES SHALL APPLY. INFORMATION ON THESE DRAWINGS SHALL HAVE THE FOLLOWING PRECEDENCE.	CONCRETE BATCHING AND CONCRETE APPROVED BY A TESTING AGENCY.
EXEMPT FROM DISABLED ACCESS REQUIREMENTS. 3. PRIOR TO THE SUBMISSION OF BIDS, THE CONTRACTORS PARTICIPATING	CONDITION OF THE SITE. THIS SHALL BE DONE AFTER THE SITE HAS BEEN AWARDED FINAL INSPECTION BY THE RESPONSIBLE	2. CONTRACTOR SHALL PREPARE ALL SURFACES AND APPLY ALL FINISHES PER LATEST EDITION OF MANUFACTURER'S SPECIFICATIONS.	A. ALL DIMENSIONS TO TAKE PRECEDENCE OVER SCALE SHOWN ON	 SEGREGATION OF AGGREGATES: CONC THROUGH REINFORCING STEEL (AS II
SHALL VISIT THE JOB SITE AND FAMILIARIZE THEMSELVES WITH ALL FIELD CONDITIONS AFFECTING THE PROPOSED PROJECT INCLUDING DEMOLITION, ELECTRICAL, MECHANICAL AND STRUCTURAL INSTALLATIONS, AS WELL AS WITH THE SPRINT CONSTRUCTION AND CONTRACT DOCUMENTS AND SHALL	BUILDING AGENCY: ONE SET OF REDLINED DRAWINGS SHALL BE PROVIDED TO THE SPRINT CONSTRUCTION MANAGER. 22. THE LATEST EDITION OF ALL PERMITTED AND APPROVED PLANS	 COMPLY WITH MANUFACTURER'S WRITTEN INSTRUCTIONS REGARDING SUFFICIENT DRVING TIME BETWEEN COATS WITH PROVISIONS AS RECOMMENDED BY MANUFACTURER FOR EXISTING WEATHER CONDITIONS. 	PLANS, SECTIONS AND DETAILS. B. NOTES AND DETAILS ON DRAWINGS SHALL TAKE PRECEDENCE OVER GENERAL NOTES AND TYPICAL DETAILS.	AND DROP CAPITALS) SO AS TO CAU USE HOPPERS, CHUTES, TRUNKS OR UNCONFINED FALL OF CONCRETE SH
CONFIRM THAT THE PROJECT CAN BE ACCOMPLISHED AS SHOWN PRIOR TO PROCEEDING WITH CONSTRUCTION. SHOULD ANY ERRORS, OMISSION, OR DISCREPANCIES BE FOUND, THE GENERAL CONTRACTOR SHALL IMMEDIATELY	PERTAINING TO THIS PROJECT SHALL BE KEPT IN A PLAN BOX AND SHALL NOT BE USED BY WORKERS, ALL CONSTRUCTION SETS SHALL REFLECT THE SAME INFORMATION. THE CONTRACTOR SHALL ALSO MANITAIN IN GOOD CONDITION. ONE COMPLETE SET OF PLANS	 FINISH COLOR AND TEXTURE OF ALL PAINTED SURFACES SHALL MATCH EXISTING ADJACENT SURFACES UNLESS OTHERWISE NOTED. 	C. MATERIAL NOTES AND SPECIFICATIONS ON THE DRAWINGS SHALL TAKE PRECEDENCE OVER THE SPECIFICATIONS.	 SPLICES OF REINFORCING STEEL SH/ DIAMETERS AND SECURELY WIRED TO REINFORCING BARS SHALL BE STAGG
NOTIFY SPRINT CONSTRUCTION MANAGER AND THE ARCHITECT IN WRITING. IN THE EVENT OF DISCREPANOIES THE CONTRACTOR SHALL INCLUDE THE MORE COSTLY OR EXTENSIVE WORK IN THE BID, UNLESS SPECIFICALLY DIRECTED OTHERWISE. IF A DISCREPANCY EXISTS AND THE PROJECT	WITH ALL REVISIONS, ADDENDA AND CHANGE ORDERS ON THE PREMISES AT ALL TIMES. THESE ARE TO BE UNDER THE CARE OF THE JOB SUPERINTENDENT.	 ALL PAINT MATERIAL DATA SHEETS SHALL BE PROVIDED TO THE SPRINT CONSTRUCTION MANAGER. 	2. OTHER TRADES: SEE THE ARCHITECTURAL DRAWINGS FOR ALL DIMENSIONS NOT SHOWN.	10. REAR CLEARANCE: MINIMUM COVERAG AND COLUMNS SHALL BE TO FACE (
MANAGER AND ARCHITECT ARE NOT NOTIFIED, THE GENERAL CONTRACTOR SHALL BE HELD RESPONSIBLE FOR ALL COSTS INCURRED TO REPAIR OR CORRECT ALL PROBLEMS THAT RESULT.	23. THE CONTRACTOR SHALL REMOVE ALL RUBBISH AND WASTE MATERIALS ON A DAILEY BASIS, EXCEPT FOR THAT SPECIFIED AS REMAINING THE PROPERTY OF THE BUILDING, OR PROPERTY OWNER	 PREPARE PREVIOUSLY PAINTED SURFACE BY LIGHT SANDING WITH 400 GRIT SANDPAPER AND NON-HYPORCARBON WASH. PREPARE GALVANIZED SURFACES BY ACID ETCH OR SOLVENT CLEANING IN ACCORDANCE WITH SSPC-SP1. 	 GENERAL DETAILS AND NOTES ON THESE SHEETS SHALL APPLY UNLESS SPECIFICALLY SHOWN OR NOTED OTHERWISE. CONSTRUCTION DETAILS NOT FULLY SHOWN OR NOTED SHALL BE 	OTHERWISE NOTED, CONCRETE COVER
4. DRAWINGS SHALL NOT BE SCALED. THESE DRAWINGS ARE INTENDED TO BE DIAGRAMMATIC ONLY. FIGURED DIMENSIONS HAVE PRECEDENCE OVER DRAWING SCALE AND DETAIL DRAWINGS HAVE PRECEDENCE OVER SMALL SCALE DRAWINGS. CONTRACTOR SHALL CHECK ACCURACY OF ALL	AND SHALL EXERCISE STRICT CONTROL OVER JOB CLEANING THROUGHOUT CONSTRUCTION, INCLUDING FINAL CLEANUP UPON COMPLETION OF WORK. ALL AREAS ARE TO BE LEFT IN A BROOM CLEAN CONDITION AT THE END OF EACH DAY AND VACUUM CLEAN	 FURNISH DROP CLOTHES, SHIELDS, MASKING AND PROTECTIVE METHODS TO PREVENT SPRAY OR DROPPINGS FROM DAMAGING ADJACENT SURFACES AND FACILITES. 	SIMILAR TO DETAILS SHOWN FOR SIMILAR CONDITIONS. 4. SHORING: IT SHALL BE THE RESPONSIBILITY OF THE CONTRACTOR	A. CONCRETE IN CONTACT WITH EAR B. CONCRETE IN CONTACT WITH EAR C. WALL, EXTERIOR FACE
DMERSIONS IN THE FIELD UNLESS SPECIFICALLY NOTED, DO NOT FABRICATE ANY MATERIALS, OR BEGIN ANY CONSTRUCTION UNTIL THE ACCURACY OF DRAWING DIMENSIONS HAS BEEN VERIFIED AGAINST ACTUAL FIELD DIMENSIONS.	CONDITION, FREE FROM PAINT SPOTS, DUST OR SMUDGES OF ANY NATURE AT COMPLETION OF WORK. 24. THE GENERAL CONTRACTOR MUST PERFORM WORK DURING PROPERTY OWNER'S PREFERRED HOURS TO AVOID DISRUPTION OF	 APPLY PAINT BY AIRLESS SPRAY, SANDING LIGHTLY BETWEEN EACH SUCCEEDING ENAMEL COAT ON FLAT SURFACES. APPLY MATERIAL TO ACHIEVE A COATING NO THINNER THAN THE DRY FILM THICKNESS INDICATED. 	TO INSTALL ALL TEMPORARY BRACING AND SHORING TO INSURE THE SAFETY OF THE WORK UNTIL IT IS IN IT'S COMPLETED FORM. THIS INCLUDES UNDERPINNING EXISTING FOOTINGS WHERE APPLICABLE.	D. WALL, INTERIOR FACE E. STRUCTURAL SLABS F. JOISTS G. BEAMS, GIRDERS & COLUMNS
 THE CONTRACTOR SHALL INCLUDE IN HIS OR HER BID ALL MATERIALS, EQUIPMENT, APPURTENANCES AND LABOR NECESSARY TO COMPLETE THE WORK AS INDICATED OR IMPLIED BY THESE DRAWINGS. 	NORMAL ACTIVITY. 25. ALL EXPOSED METAL SHALL BE HOT-DIPPED GALVANIZED.	 APPLY BLOCK FILTER TO CONCRETE BLOCK CONSTRUCTION AT A RATE TO ENSURE COMPLETE COVERAGE WITH PORES COMPLETELY FILLED. CONTRACTOR OF THE CARDON MARKED AND CONTRACTOR OF THE CARDON AND CARDON AND	 SAFETY: THESE STRUCTURAL DRAWINGS REPRESENT THE FINISHED STRUCTURE. UNLESS OTHERWISE INDICATED, THEY DO NOT INDICATE THE METHOD OF CONSTRUCTION. 	 PENETRATIONS: NO SLEEVES OR CHA BEAMS, SLABS, WALLS AND COLUMNS PLANS. CONTRACTOR SHALL OBTAIN
6. CONTRACTOR SHALL NOTIFY THE SPRINT CONSTRUCTION MANAGER, THE PROPERTY OWNER AND THE ARCHITECT IF ANY DETAILS ARE CONSIDERED IMPRACTICAL, UNSUITABLE, UNSAFE, NOT WATERPROOF, OR NOT	26. SEAL ALL PENETRATIONS THROUGH FIRE-FATED AREAS WITH U.L. LISTED OR FIRE MARSHALL APPROVED MATERIALS IF AND WHERE APPLICABLE TO THIS FACILITY AND PROJECT STE.	 CONTRACTOR SHALL CORRECT RUNS, SAGS, MISSES AND OTHER DEFECTS INCLUDING INADEQUATE COVERAGE AS DIRECTED BY THE SPRINT CONSTRUCTION MANAGER. REPAINT AS NECESSARY TO ACHIEVE SURFACES WHICH ARE SMOOTH, EVENLY COATED WITH UNIFORM SHEEN AND FREE FROM BLEMISHES. 	 WATERPROOFING: WATERPROOFING AND DRAINAGE, DETAILS AND SPECIFICATIONS, ALTHOUGH SOMETIMES SHOWN ON STRUCTURAL 	INSTALLATIONS OF ANY ADDITIONAL S PLUMBING, ELECTRICAL AND MECHANI SLEEVES. CORING IS NOT ALLOWED U
WITHIN CUSTOMARY TRADE PPACTICE. IF WORK IS PERFORMED, IT WILL BE ASSUMED THAT THERE IS NO OBJECTION TO ANY DETAIL. DETAILS ARE INTENDED TO SHOW THE END RESULT OF THE DESIGN. MINOR MODIFICATIONS MAY BE REQUIRED TO SUIT JOB CONDITIONS, AND SHALL BE	27. PROVIDE A PORTABLE FIRE EXTINGUISHER WITH A RATING OF NOT LESS THAN 2-A OR 2-A10BC WITHIN 75 FEET TRAVEL DISTANCE TO ALL PORTIONS OF THE PROJECT AREA CONSTRUCTION.	B. PAINTING SCOPE 1. PAINT THE FOLLOWING MATERIALS AND SYSTEMS CHECKED BELOW	DRAWING ARE OF GENERAL INFORMATION PURPOSES ONLY. WATERPROFING AND DRAINAGE ARE SOLELY THE DESIGN RESPONSIBILITY OF THE ARCHITECT.	OBTAINED FROM THE STRUCTURAL EN 12. EMBEDDED ITEMS: CONDUIT PLACED I NOT HAVE AN OUTSIDE DIAMETER OF
INCLUDED AS PART OF THE WORK. 7. EXISTING ELEVATIONS AND LOCATIONS TO BE JOINED SHALL BE VERIFIED BY	28. ELECTRICAL POWER SYSTEM SHALL BE GROUNDED PER NEC ARTICLES 250 AND 810.	WITH THE FOLLOWING MATERIALS AND STSTEMS CHECKED BELOW WITH THE COATING SYSTEM INDICATED.	B. STEEL	NOT HAVE AN OUTSIDE DIAMETER GR OF THE SLAB. CONDUIT SHALL NOT IS LESS THAN 3–1/2" THICK, UNLES
THE CONTRACTOR BEFORE CONSTRUCTION. IF THEY DIFFER FROM THOSE SHOWN ON THE PLANS, THE CONTRACTOR SHALL NOTIFY THE SPRINT CONSTRUCTION MANAGER AND THE ARCHITECT SO THAT MODIFICATIONS CAN BE MADE BEFORE PROCEEDING WITH THE WORK.	29. ALL NEW OPENINGS IN THE EXTERIOR ENVELOPE OF CONDITIONED SPACES SUCH AS AT WALL AND ROOF PENETRATIONS SHALL BE CAULKED OR SEALED TO LIMIT INFILTRATION OF AR AND MOISTURE.	PAINTING SCOPE SUPPACE TO BE PARTED CONTROL TO BE P	 ALL STRUCTURAL STEEL SECTIONS AND WELDED PLATE MEMBERS SHALL CONFORM TO ASTM A-36 AND BE FABRICATED IN ACCORDANCE WITH THE SPECIFICATIONS OF THE AISC. 	MINIMUM CLEAR DISTANCE BETWEEN 13. ANCHORING: ALL ANCHOR BOLTS, RE INSERTS, ETC.,SHALL BE WELL SECUI
 THE CONTRACTOR SHALL VERIFY ALL TELEPHONE & RADIO EQUIPMENT LAYOUTS, SPECIFICATIONS, PERFORMANCE, INSTALLATION AND FINAL LOCATIONS WITH SPRINT CONSTRUCTION MANAGER PRIOR TO 	30. UPON COMPLETION OF CONSTRUCTION, SPRINT CONSTRUCTION MANAGER SHALL CONDUCT A WALK-THRU WITH PROPERTY OWNER OR REPRESENTATIVE OF PROPERTY OWNER.	HIGH STRENGTH BOLTS SHALL CONFORM TO ASTM A-325 	PLACING CONCRETE. NO REPOSITIONI IS ALLOWED.
BEGINNING WORK. THE CONTRACTOR SHALL BE RESPONSIBLE FOR COORDINATING HIS WORK WITH ERICSSON RADIO SYSTEMS. 9. ALL SYMBOLS & ABBREVIATIONS USED ON THE DRAWINGS ARE	31. THE CONTRACTOR SHALL BE RESPONSIBLE FOR MAINTAINING ALL SYSTEM EQUIPMENT IN A CLEAN WORKING ORDER UNTIL ACCEPTANCE OF THE PROJECT BY SPRINT.	PLYMOD, LUNER AND WOOT THIN ANALUMIG VIEWLAND FOR AN INFORMATION ANALUMIC VIEWLAND AND ANALUMIC ANALUMIC ANALUMIC ANALUMIC ANALUMIC ANALUMIC ANALUMIC OKONET FALSE WICE, TAUS AND WICE FALS STAND-OFF	3. STEEL PIPE COLUMNS SHALL BE GRADE "B" CONFORMING TO ASTM A53.	 CURING: SLABS SHALL BE SPRAYED IMMEDIATELY AFTER FINISHING. CURIN CONCRETE WHERE TILE OR FLOOR C TO THE CONCRETE SURFACE SHALL
CONSIDERED CONSTRUCTION STANDARDS. IF THE CONTRACTOR HAS QUESTIONS REGARDING THEIR EXACT MEANING, THE SPRINT CONSTRUCTION MANAGER AND THE ARCHITECT SHALL BE NOTIFIED FOR	32. INSTALL ALL EQUIPMENT AND MATERIALS PER THE LATEST EDITION OF THE MANUFACTURER'S INSTALLATION SPECIFICATIONS UNLESS	C. COATING SYSTEM SPECIFICATIONS 1. DTM ACRYLIC COATING (SERIES B66) BY SHERWIN WILLIAMS CO. 1MIL DFT PER	4. STEEL TUBING SHALL BE GRADE "B" CONFORMING TO ASTM A500.	OR FLOOR COVERING MANUFACTURER MINIMUM PERIOD.
CLARIFICATION BEFORE THE CONTRACTOR PROCEEDS WITH THE WORK. 10. THE CONTRACTOR SHALL OBTAIN AND PAY FOR PERMITS, LICENSES AND INSPECTIONS NECESSARY FOR PERFORMANCE OF THE WORK AND INCLUDE THOSE IN THE COST OF THE WORK TO SPRINT.	SPECIFICALLY OTHERWISE INDICATED, OR WHERE LOCAL CODES OR REGULATION TAKE PRECEDENCE. 33. NOTIFY SPRINT PRIOR TO ANY RF OR SITE CONCERNS 1-866-400-6040.	COAT APPLIED IN TWO COATS OVER DTM BONDING PRIMER (B66A50). 2. 100% ACRYLIC, LATEX COATING EQUIVALENT TO A-100 (SERIES A-82) BY SHERWIN WILLIAMS CO. 1 MIL DTT PER COAT APPLIED IN TWO COATS OVER SPECIFIED PRIMER.	 ALL WELDING SHALL BE DONE BY THE SHIELDED ARC METHOD. ALL WELDERS SHALL BE PROPERLY QUALIFED AND BE PRE-APPROVED. SURPLUS METAL SHALL BE DRESSED OFF TO SMOOTH, EVEN SURFACES WHERE WELDS ARE NOT EXPOSED TO VIEW. ALL WELDING SHALL COMPLY WITH THE LATEST A.W.S. SPECIFICATIONS. 	15. CONSOLIDATION: ALL CONCRETE SHAL BEING PLACED WITH ELECTRICALLY O D. TIMBER
11. THE CONTRACTOR SHALL PROVIDE CONTINUOUS SUPERVISION WHILE ANY SUBCONTRACTORS ON WORKMEN ARE IN THE SITE AND SHALL SUPERVISE		PAINT & PRIMER	6. THE FOLLOWING WELDING EQUIPMENT MUST BE USED:	 ALL FRAMING LUMBER FOR 4X AND GRADE DOUGLAS FIR., S45, UNLESS DRAWINGS.
AND DIRECT ALL WORK, USING HIS BEST SKILL AND ATTENTION. HE SHALL BE SOLELY RESPONSIBLE FOR ALL CONSTRUCTION MEANS, METHODS, TECHNIQUES, PROCEDURES AND SEQUENCES AND FOR COORDINATING ALL	ROOFING & WATERPROOFING NOTES	D. ANTENNAS PRIMER – KEM AQUA E61-W525 TOPCOAT – COROTHANE II B65W200/B60V22	A. 250 AMP WELDERS. B. ROD OVENS. C. GRINDERS.	2. ALL FRAMING LUMBER FOR 2X RAFTE
PORTING OF THE WORK UNDER THE CONTRACT.	 CONTRACTOR SHALL CONTACT BUILDING OWNER TO DETERMINE IF ROOF IS UNDER WARRANTY. CONTRACTOR SHALL GUARANTEE THAT ANY AND ALL NEW ROOFING WORK MEETS THE SPECIFICATION OF ANY EXISTING 	BTS CABINET	7. NO BUZZ BOXES SHALL BE USED.	GRADE DOUGLAS FIR, S45, UNLESS
TRADE INVOLVED, AND SHALL MEET OR EXCEED THE FOLLOWING MINIMUM REFERENCE STANDARDS FOR QUALITY AND PROFESSIONAL CONSTRUCTION PRACTICE:	ROOFING WARRANTIES SUCH THAT THE WARRANTY IS NOT MADE INVALID AS A RESULT OF THIS WORK. IF IT IS DETERMINED THAT THE ARCHITECT'S DETAILING IS INADEQUATE OR IMPROPER OR IF ANY OTHER DISCREPANCY IS FOUND. THE CONTRACTOR SHALL IMMEDIATELY NOTIFY	PRIMER – KEM AQUA E61-W525 TOPCOAT – COROTHANE II B65W200/B60V22 COAXIAL JUMPER CABLES	 ALL STRUCTURAL STEEL SHALL MILL CERTIFICATION. MILL CERTIFICATION SHALL BE KEPT ON THE JOB SITE FOR EXAMINATION BY THE DESIGN ENGINEER AND THE CITY INSPECTOR. 	LUMBER SHALL BE NO. 2 OR STD & 2X4 STUD WALLS SHALL BE D.F. S
NRCA NATIONAL ROOFING CONTRACTORS ASSOCIATION O'HARE INTERNATIONAL CENTER 10255 W. HIGGENS ROAD, SUITE 600	THE ARCHITECT AND THE SPRINT PROJECT MANAGER IN WRITING, ULTIMATELY, THE CONTRACTOR SHALL BE RESPONSIBLE FOR COMPLYING WITH THE ORIGINAL ROOF MANUFACTURER'S SPECIFICATIONS.	PRIMER – AS REQUIRED FOR ADHESION. APPLY ONE COAT OF KEM AQUA WATER REDUCIBLE PRIMER EG1W25 REDUCED 25% TOPCOAT – 2 COATS COROTHANE II POLYURETHANE B65W200/B60V2	 ALL HIGH STRENGTH BOLTS SHALL HAVE MILL CERTIFICATION. MILL CERTIFICATION SHALL BE KEPT ON THE JOB SITE FOR EXAMINATION BY THE INSPECTOR. 	 ALL BEAMS, JOISTS AND RAFTERS SH SIDE UP. ROOF PLYWOOD SHALL MATCH EXISTI
ROSEMONT, IL 60018 SMACNA SHEET METAL AND AIR CONDITIONING CONTRACTORS NATIONAL ASSOCIATION	 CONTRACTOR SHALL USE METHODS AND MATERIALS SIMILAR AND COMPATIBLE WITH EXISTING MATERIALS & CONDITIONS FOR ROOF PATCHING, NEW PENERATIONS, ETC. 	RAW STEEL PRIMER - KEM BOND HS B50WZ4, DMT ACRYLIC PRIMER TOPCOAT - 2 COATS COROTHANE II POLYURETHANE B65W200/B60V2	10. STEEL THAT HAD BEEN WELDED, CUT OR SCRATCHED IN THE FIELD SHALL BE TOUCHED UP WITH COLD GALVANIZING PAINT.	SPAN INDEX RATIO 32/16. EDGE N NOTED OTHERWISE ON PLANS. FIELD
4201 LAFAYETTE CENTER DRIVE CHATILLY, VA 22021–1209 ITLP INTERNATIONAL INSTITUTE FOR LATH AND PLASTER	 THE CONTRACTOR SHALL PROPERLY SEAL ALL NEW ROOF & BUILDING ENVELOPE PERLETRATIONS SUCH THAT THE INTEGRITY OF THE ORIGINAL BUILDING ASSEMBLY AND ALL APPLICABLE WARRANTES ARE MAINTAINED. 	GALVANIZED METAL ACID ETCH WITH COMMERCIAL ETCH OR VINEGAR PRIMER COAT AND FINISH COAT (GALVITE HIGH SOLIDS OR DTM PRIMER/FINISH)	11. WELDING INDICATED IN THESE DRAWINGS IS DESIGNED FOR ONE HALF OF ALLOWABLE CODE STRESSES UNLESS SPECIFICALLY NOTED	 PLYWOOD SHEETS SHALL BE LAID WI PERPENDICULAR TO SUPPORTS AND UNLESS NOTED OTHERWISE ON THE
820 TRANSFER ROAD ST. PAUL, MN 55114-1406	4. IF IT DEEMED NECESSARY TO REMOVE EXISTING FINISHES AND/OR MATERIALS, THE CONTRACTOR SHALL BE RESPONSIBLE FOR	STAINLESS STEL PRIMER – OTM WASH PRIMER, B71Y1	"FULL STRESS" AT END OF WELD SYMBOL. C. CONCRETE	 PLYWOOD SHALL BE GRADE MARKED SHALL CONFORM TO PS 1-83.
 INSTALL ALL EQUIPMENT AND MATERIALS PER THE LATEST EDITION OF THE MANUFACTURER'S INSTALLATION SPECIFICATIONS UNLESS SPECIFICALLY OTHERWISE INDICATED, OR WHERE LOCAL CODES OR REGULATIONS TAKE PRECEDENCE. 	RECONSTRUCTING FINISHES AND MATERIALS TO LIKE-NEW CONDITION. CONTRACTOR SHALL MAINTAIN THE ORIGINAL COLORS, TEXTURES & FINISHES UNLESS SPECIFICALLY NOTED TO THE CONTRARY OR APPROVED BY THE SPIRIT CONSTRUCTION MANAGER IN	TOPCOST - 2 CONTACTS CONCILIANE II POLYURETHANE B65W200/B60V2 PRE-PRIMED STEEL	1. STRENGTH: CONCRETE FOR THE PROJECT SHALL HAVE THE FOLLOWING ULTIMATE COMPRESSIVE STRENGTH AT AGE OF 28 DAYS:	8. THE MAXIMUM MOISTURE CONTENT O EXCEED 24% AT THE TIME OF INSTAL
14. THE CONTRACTOR SHALL VERIFY, COORDINATE, AND PROVIDE ALL NECESSARY BLOCKING, BACKING, FRAMING, HANGARS OR OTHER SUPPORTS	ADVANCE. 5. AT THE SPRINT CONSTRUCTION MANAGER'S DIRECTION,	TOUCH UP ANY RUST OR UN-PRIMED STEEL WITH KEM BOND HS, SSOWZ4	LOCATION STRENGTH WT. SLUMP ADMIXTURE A. SLAB&FOOTING 3000psi 150pcf 4" NONE	 MINIMUM NAILING SHALL COMPLY WIT CODE. ALL NAILS SHALL BE COMMON
FOR ALL ITEMS REQUIRING THE SAME. 15. THE CONTRACTOR AND ALL SUBCONTRACTORS SHALL GIVE ALL NOTICES AND SHALL COMPLY WITH ALL APPLICABLE LOCAL CODES, REGULATIONS, LAWS	THE CONTRACTOR SHALL PROVIDE ROOFTOP WALK PADS TO ALL NEW EQUIPMENT INCLUDING ANTENNAS AND BTS UNITS AND ALONG COAX CABLE ROUTING. ON CONVENTIONAL ROOFING, THE WALK PADS SHALL BE "DUCK BOARDS" AS MANUFACTURED BY APC OR EQUAL ON	PRIMER – DTM WASH PRIMER, B71Y1 TOPCOAT – 2 COATS COROTHANE II POLYURETHANE B65W200/B60V2	2. INSPECTION: CONCRETE WITH SPECIFIED STRENGTH GREATER THAN 2500psi SHALL BE CONTINUOUSLY INSPECTED DURING PLACEMENT	10. ALL BOLTS SHALL HAVE STANDARD C AND/OR NUTS WHERE IN CONTACT V
AND ORDINANCES AS WELL AS STATE DEPARTMENT OF INDUSTRIAL REGULATIONS AND DIVISION OF INDUSTRIAL SAFETY (OSHA) REQUIREMENTS.	BERCIAL ROOFING STSTEMS SUCH AS INDEE BEFF ON DELTA ON OF WILL REQUIRE A SPECIFIC PRODUCT AS NOTED ON PLANS OR AS REQUIRED BY NOTES 1 & 2 ABOVE.	CONCRETE MASONRY PRIMER - PRO MAR EXTERIOR BLOCK FILLER TOPCOAT - 2 COATS A-100 LATEX HOUSE & TRIM, SHEEN TO MATCH	BY A DEPUTY INSPECTOR EMPLOYED BY A TESTING LABORATORY APPROVED BY THE BUILDING DEPT. 3. REBAR GRADES: REINFORCING STEEL SHALL BE CLEAN PERFORMED	11. LAG BOLTS SHALL BE SCREWED INTO BOLTS SHALL BE INSTALLED IN PRE- DIAMETER EQUAL TO 75% DIAMETER
16. THE CONTRACTOR SHALL PROTECT THE PROPERTY OWNERS, AND SPRINT PROPERTY FROM DAMAGE WHICH MAY OCCUR DURING CONSTRUCTION. ANY DAMAGE TO NEW AND EXISTING FINISHES, CONSTRUCTION, STRUCTURE, LANDSCAPING, CURBS, STAIRS, OR EQUIPMENT,	PENETRATION AT FIRE RATED ASSEMBLIES	CONCRETE STUCCO(EXISTING) 2 COATS A-100 LATEX HOUSE & TRIM, SHEEN TO MATCH	BARS CONFORMING TO ASTM A615 AS FALLOWS: #4 & SMALLER BARS	12. CONNECTORS: ALL SHEET METAL FRA THE PLANS SHALL BE STRONG CONN THE SAMSON COMPANY. SUBSTITUTIO
ETC. SHALL BE IMMEDIATELY REPAIRED OR REPLACED TO THE SATISFACTION OF SPRINT, AND THE PROPERTY OWNER'S REPRESENTATIVE, AT THE EXPENSE OF THE CONTRACTOR.	1. AT THE SPRINT PROJECT MANAGER'S DIRECTION, THE CONTRACTOR SHALL PROVIDE "HILTI" HICH PERFORMANCE FIRE STOP	STUCCO PRIMER – PRO MAR MASONRY CONDITONER B-46-W21000 TOPCOAT – SUPER PAINT A-80 SERIES A-89 SATIN A-84 GLOSS	#5 & LARGER BARSGRADE 60 ALL BARS AT CAISSON FOOTINGGRADE 60	APPROVED BY THE STRUCTURAL ENG 13. ALL LUMBER EXPOSED TO WEATHER
17. THE CONTRACTOR SHALL BE RESPONSIBLE FOR, AND SHALL REPLACE OR REMEDY, ANY FAULTY, IMPROPER, OR INFRIOR MATERIALS OR WORKMANSHIP OR ANY DAMAGE WHICH SHALL APPEAR WITHIN ONE YEAR AFTER THE COMPLETION AND ACCEPTANCE OF THE WORK BY SPRINT UNDER THE CONTRACT, AND ACCEPTANCE OF THE WORK BY SPRINT	SYSTEM #FS601 AT ALL FIRE RATED PENETRATIONS INSTALLED PER MANUFACTURER'S LATEST INSTALLATION SPECIFICATIONS. 2. ALL PENETRATIONS THROUGH FIRE RATED ASSEMBLIES SHALL BE CONSTRUCTED SO AS TO MAINTAIN AN EQUAL OR OREATER FIRE RATING.	WOOD PRIMER – A-100 EXTERIOR ALKYD WOO9D PRIMER Y-24W20 TOPCOAT – 2 COATS A-100 LATEX HOUSE & TRIM SHEEN TO MATCH ADJACENT SURFACES	 CEMENT: FOUNDATIONS & SLABS: TYPE V, LOW ALKALI, CONFORMING TO ASTM C-150. PIER/CAISSON FOOTINGS: TYPE V, LOW ALKALI, CONFORMING TO ASTM C-150. 	OR CONCRETE SHALL BE WOLMANIZE OR A NATURALLY DECAY RESISTANT I CEDAR.
UNDER THIS CONTRACT. 18. IT SHALL BE THE RESPONSIBILITY OF THE GENERAL CONTRACTOR TO LOCATE ALL EXISTING UTILITIES, OR CONTRACT AN OUTSIDE AGENCY TO LOCATE ALL EXISTING UTILITIES, WHETHER SHOWN HEREIN OR NOT, AND	WORK ENVIRONMENT	FIELD CUTS/DAMAGE(PRIOR TO PRIME & PAINT) FIRST & SECOND COAT - CUPRINOL CLEAR WOOD PRESERVATIVE #158-0356 ALL PENETRATIONS INTO FINISHED CLU-LAMS SHALL BE	 AGGREGATE: USED IN THE CONCRETE SHALL CONFORM TO ASTM C-33. USE ONLY AGGREGATES KNOWN NOT TO CAUSE EXCESSIVE SHRINKAGE. THE MAXIMUM SIZE AGGREGATE IN CONCRETE WORK 	 ALASKAN YELLOW CEDAR GLUE-LAMIN A. LUMBER SPECIES: ALASKAN YELLO TO 20F-V12 B. STRENGTH PROPERTIES:
DUCATE ALL EXISTING UTILITIES, WHETHER SHOWN HEREIN OR NOT, AND TO PROFECT THEM FROM DAMAGE. THE CONTRACTOR SHALL BEAR ALL EXPENSES FOR THE REPAR OR REPLACEMENT OF UTILITIES OR OTHER PROPERTY DAMAGED IN CONJUNCTION WITH THE EXECUTION OF WORK.	1. CONTRACTOR AND CREW SHALL ABIDE BY THE UNITED STATES DEPARTMENT OF LABOR'S OCCUPATIONAL SAFETY AND HEALTH ADMINISTRATION STANDARDS (OSHA) AS DESCRIBED IN OSHA'S HANDBOOK OF GUIDELINES.	CAULKED WITH "SIKAFLEX" SEALANT STEEL TOUCH UP	SHALL BE THE FOLLOWING: A. FOUNDATIONS & SLABS 9" OR LESS: 3/4" GRAVEL	Fb BOTTOM FIBER BENDING STRE Fb TOP FIBER BENDING STRESS Fv SHEAR STRESS 190psi MIN.
 THE CONTRACTOR SHALL BE RESPONSIBLE FOR THE COMPLETE SECURITY OF THE PROJECT SITE WHILE THE JOB IS IN PROGRESS AND UNTIL THE JOB IS COMPLETED AND ACCEPTED BY SPRINT. 	COSTAY AS DESCRIBED IN OSTAR S HANDBOOK OF GUIDELINES. 2. CONTRACTOR AND CREW SHALL ABIDE BY SPRINT STANDARDS AS DESCRIBED IN SPRINT'S SAFETY HANDBOOK.	STEEL THAT HAS BEEN WELDED, CUT OR SCRATCHED IN THE FIELD SHALL BE TOUCHED UP WITH COLD GALVANIZED PAINT	B. PIER/CAISSON FOOTING: 1" GRAVEL. 6. WATER: SHALL BE CLEAN AND FREE FROM DELETERIOUS AMOUNT	Fc COMPRESSION STRESS PERPE E MODULES ELASTICITY 1400ksi C. CAMBER TO RADIUS OF 1600° U.C
UUL IS COMPLETED AND ACCEPTED BI SPRINT.			OF ACIDS, ALKALIS, ORGANIC MATERIALS AND SHALL BE SUITABLE FOR HUMAN CONSUMPTION.	C. CAMUELA TO MAINS OF THOM OF D. ALL GLB'S SHALL BE FABRICATED E. MANUFACTURE OF GLB'S SHALL C F. GLU-LAM MATERIAL SHALL BE IN A190.1 AND ASTM D3737.
			1	ATYU.I AND ASIM 03/3/.

RATION OF CONCRETE SHALL CONFORM TO ASTM 2E THAN 90 MINUTES SHALL ELAPSE BETWEEN CHING AND CONCRETE PLACEMENT UNLESS A TESTING AGENCY.

AGGREGATES: CONCRETE SHALL NOT BE FLOPPED ORCING STEEL (AS IN WALLS, COLUMNS, CAISSON, TALS) SO AS TO CAUSE SEGREGATION OF AGGREGATES CHUTES, TRUNKS OR PUMP HOSE SO THAT THE FREE ALL OF CONCRETE SHALL NOT EXCEED 5 FT.

INFORCING STEEL SHALL BE LAPPED A MINIMUM OF 30 SECURELY WIRED TOGETHER. SPLICES OF ADJACENT ARS SHALL BE STAGGERED WHEREVER POSSIBLE.

E: MINIMUM COVERAGE FOR JOISTS, BEAMS, GIRDERS SHALL BE TO FACE OF STIRRUPS OR TIES. UNLESS ED, CONCRETE COVERAGE FOR REINFORCING BARS TO SHALL BE AS FOLLOWS:

CONTACT WITH EARTH, UNFORMED CONTACT WITH EARTH, FORMED 1-1/2" IOR FACE OR FACE SLABS

3/4" 3/4" 1-1/2"

NO SLEEVES OR CHASES SHALL BE PLACED IN WALLS AND COLUMNS, EXCEPT THOSE SHOWN ON THE ACTOR SHALL OBTAIN PRIOR APPROVAL FOR OF ANY ADDITIONAL SLEEVES OR CHASES. ALL CIRICAL AND MECHANICAL OPENINGS SHALL BE NG IS NOT ALLOWED UNLESS PRIOR APPROVAL IS M THE STDUCTURAL ENDINEER THE STRUCTURAL ENGINEER

S: CONDUIT PLACED IN A CONCRETE SLAB SHALL OUTSIDE DIAMETER GREATER THAN 1/4 THE THICKNESS CONDUIT SHALL NOT BE EMBEDDED IN A SLAB THAT 3-1/2" THICK, UNLESS SLAB IS LOCALLY THICKENED. DISTANCE BETWEEN CONDUITS SHALL BE SIX INCHES

L ANCHOR BOLTS, REINFORCING STEEL, DOWELS, SHALL BE WELL SECURED IN POSITION PRIOR TO RETE. NO REPOSITIONING DURING CONCRETE POUR

SHALL BE SPRAYED WITH A CURING COMPOUND TER FINISHING, CURING COMPOUNDS USED ON RE TILE OR FLOOR COVERING IS TO BE BONDED ETE SURFACE SHALL BE APPROVED BY THE TILE ERING MANUFACTURER. KEEP SLAB WET FOR 7 DAY

ALL CONCRETE SHALL BE VIBRATED AS IT IS WITH ELECTRICALLY OPERATED VIBRATING EQUIPMENT.

UMBER FOR 4X AND LARGER BEAMS SHALL BE NO. 1 S FIR., S45, UNLESS NOTED OTHERWISE ON THE

UMBER FOR 2X RAFTERS AND JOISTS SHALL BE NO.2 S FIR, S45, UNLESS NOTED OTHERWISE ON DRAWINGS

CKING BACKING AND OTHER NON-STRUCTURAL BE NO. 2 OR STD & BTR GRADE DOUGLAS FIR, S4S. LS SHALL BE D.F. STANDARD & BTR.

ISTS AND RAFTERS SHALL BE INSTALLED WITH CROWN

SHALL MATCH EXISTING PLYWOOD SHEATHING WITH A ATIO 32/16. EDGE NAIL WITH8d AT 6" O.C. UNLESS ISE ON PLANS. FIELD NAIL WITH 8d AT 12" O.C.

TS SHALL BE LAID WITH THE FACE GRAIN TO SUPPORTS AND WITH THE EDGES STAGGERED, OTHERWISE ON THE PLANS.

BE GRADE MARKED BY DFPA, TECO, OR PTL AND I TO PS 1-83.

MOISTURE CONTENT OF ALL LUMBER SHALL NOT T THE TIME OF INSTALLATION.

SHALL COMPLY WITH TABLE 23-1-q OF BUILDING SHALL BE COMMON WIRE NAILS.

ALL HAVE STANDARD CUT WASHERS UNDER HEADS HERE IN CONTACT WITH WOOD.

ALL BE SCREWED INTO PLACE, NOT DRIVEN. LAG INSTALLED IN PRE-DRILLED HOLES WITH A TO 75% DIAMETER OF BOLT.

ALL SHEET METAL FRAMING CONNECTORS SHOWN IN ALL BE STRONG CONNECTORS AS MANUFACTURED BY COMPANY. SUBSTITUTIONS MAY BE MADE WHEN HE STRUCTURAL ENGINEER.

POSED TO WEATHER OR IN CONTACT WITH MASONRY HALL BE WOLMANIZED PRESSURE TREATED LUMBER Y DECAY RESISTANT LUMBER SUCH AS REDWOOD OR

W CEDAR GLUE-LAMINATED BEAMS ECIES: ALASKAN YELLOW CEDAR (A.C.) CONFORMING ROPERTIES:

HCPERUIES: HERE BENDING STRESS 2000psi MIN. SER BENDING STRESS 1000psi MIN. STRESS 100psi MIN. ESSION STRESS PERPENDICULAR TO GRAIN 560psi MIN. S ELASTICITY 1400ksi MIN. RADIUS OF 1600' U.O.N. SHALL BE FABRICATED WITH EXTERIOR GLUE. ST OF CHE'S CHAIL CONFORM TO THE UPC

LEE OF GLB'S SHALL CONFORM TO THE UBC. ATERIAL SHALL BE IN ACCORDANCE WITH ANSI/AITC ASTM D3737.

Sprint



200 Spectrum Center Drive, Suite 1700 Irvine, California 92618



Jeffrey Rome ASSOCIATES architecture | telecommunications

131 Innovation Drive, Suite 100 Irvine, California 92617 tel 949 760 3929 | fax 949 760 3931

		REVISIONS		
REV.	DATE	DESCRIPTION	INIT.	
1	08/16/17	90% CD REVIEW	MS	
2	08/28/17	100% FINAL CD'S	MS	
3	09/06/17	CLIENT COMMENTS	BV	A
4	12/13/17	PC COMMENTS	MS	
5				
	NOT FOR	CONSTRUCTION UNLESS		

LABELED AS CONSTRUCTION SET



SITE INFORMATION:

VR03XC049 CROWN SITE: 881022 PITAS POINT

3945 PACIFIC COAST HIGHWAY VENTURA, CALIFORNIA 93002 VENTURA COUNTY

SHEET TITLE:


SPECIFICATIONS AND NOTES


SHEET NUMBER


-2


	 NOTES TO CONTRACTOR: REMOVE ALL EXISTING CDMA COAX AND ANTENNAS FROM SITE. NEW ANTENNAS AND HARDWARE TO BE PAINTED TO MATCH EXISTING BUILDING OR POLE. CONTRACTOR TO SET ELECTRICAL TILT. ALL TOWER MOUNTED EQUIPMENT MUST BE BEHIND THE (N) SPRINT ANTENNA. EQUIPMENT MUST BE WITHIN & VERTICAL SPACE. ALL PANEL ANTENNAS AND RELATED HARDWARE MUST BE PAINTED TO MATCH EXISTING MONOPOLE. 	SECTOR ANTENNA AZIMUTH RAD CENTER NUMBER OF ANTENNAS ANTENNA MODEL RRH RRH MODEL 1 800/2500 800/1900 110° 20.0° 1 APXVTSM18-C-I20 1 RRH 1900 4X45 65 MHz (1) HY HB1° 2 800/2500 800/1900 220° 20.0° 1 APXVTSM18-C-I20 1 RRH 2.5 TD-RRH8X20 (1) HY HB1° 2 800/2500 800/1900 220° 20.0° 1 APXVTSM18-C-I20 1 RRH 2.5 TD-RRH8X20 (1) HY HB1°
		3 TOTAL (1) LINE OF 5/8"# FOR ALL (3) SECTORS IMPORTANT NOTE: INSTALLER VERIFY LATEST PLUMBING/WIRING DIAGRAMS, F VERIFY CURRENT RFDS SHEET PRIOR TO E
Existing Cable Tray.		EXISTING MONOPOLE. EXISTING CAU WALL WITH WOOD FENCE ENCLOSURE. PROPOSED SPIRIT ANTENNAS MONOPOLE: SEE SHEET A-3. EXISTING FIBER CABINET. EXISTING FIBER CABINET. EXISTING BBU CABINET. EXISTING BBU CABINET. EXISTING POWER/TELCO CABINET. EXISTING TRANSFORMER.
ENLARGED SITE PLAN		11x17 SCALE: 3/1 24x36 SCALE: 3/8


								1
FIBER OPTIC MODEL	FIBER OPTIC LENGTH (±5')	JUMPER CABLE LENGTH (±5')	COMBINER MODEL		Spri	int' 🄰		
HYBRIFLEX 1-1/4"ø IB114-1-08U4-M5J	40'	10'	N/A		'P''	11		
) HYBRIFLEX 1-1/4"ø IB114-1-08U4-M5J	40'	10'	N/A					
				(CROW CASTL	.E	
, PRIOR TO INS	STALLATIO	۷.		PLANS PR	EPARED BY:	rvine, California 92618		
BUILD		SCALE:	2			jra		
		NONE			architect 131 Inn Irvine	ey Rome ASSOCIATE ture telecommunications ovation Drive; Sulte 100 , California 92617 60.3929 fax 949.760.3931	s	
						REVISIONS		
				REV.	DATE	DESCRIPTION	INIT.	
					08/16/17 08/28/17	90% CD REVIEW	MS MS	
					09/06/17	CLIENT COMMENTS	BV	/↑
				4	12/13/17	PC COMMENTS	MS	
20						CONSTRUCTION UNLESS AS CONSTRUCTION SET	1	
				SITE I	NFORMATION	R03XC049		
					CROWN	SITE: 881022		
					3945 PA VENTUR/	CIFIC COAST HIGHWAY A, CALIFORNIA 93002 NTURA COUNTY		
			N	SHEET		GED SITE PLAN		34
				SHEET	NUMBER:	JU JIE PLAN		BER: 17158
$\frac{5}{16"=1'-0"}$	1'2'3'			$\left \right $		4-2		JRA JOB NUMBER: 171584

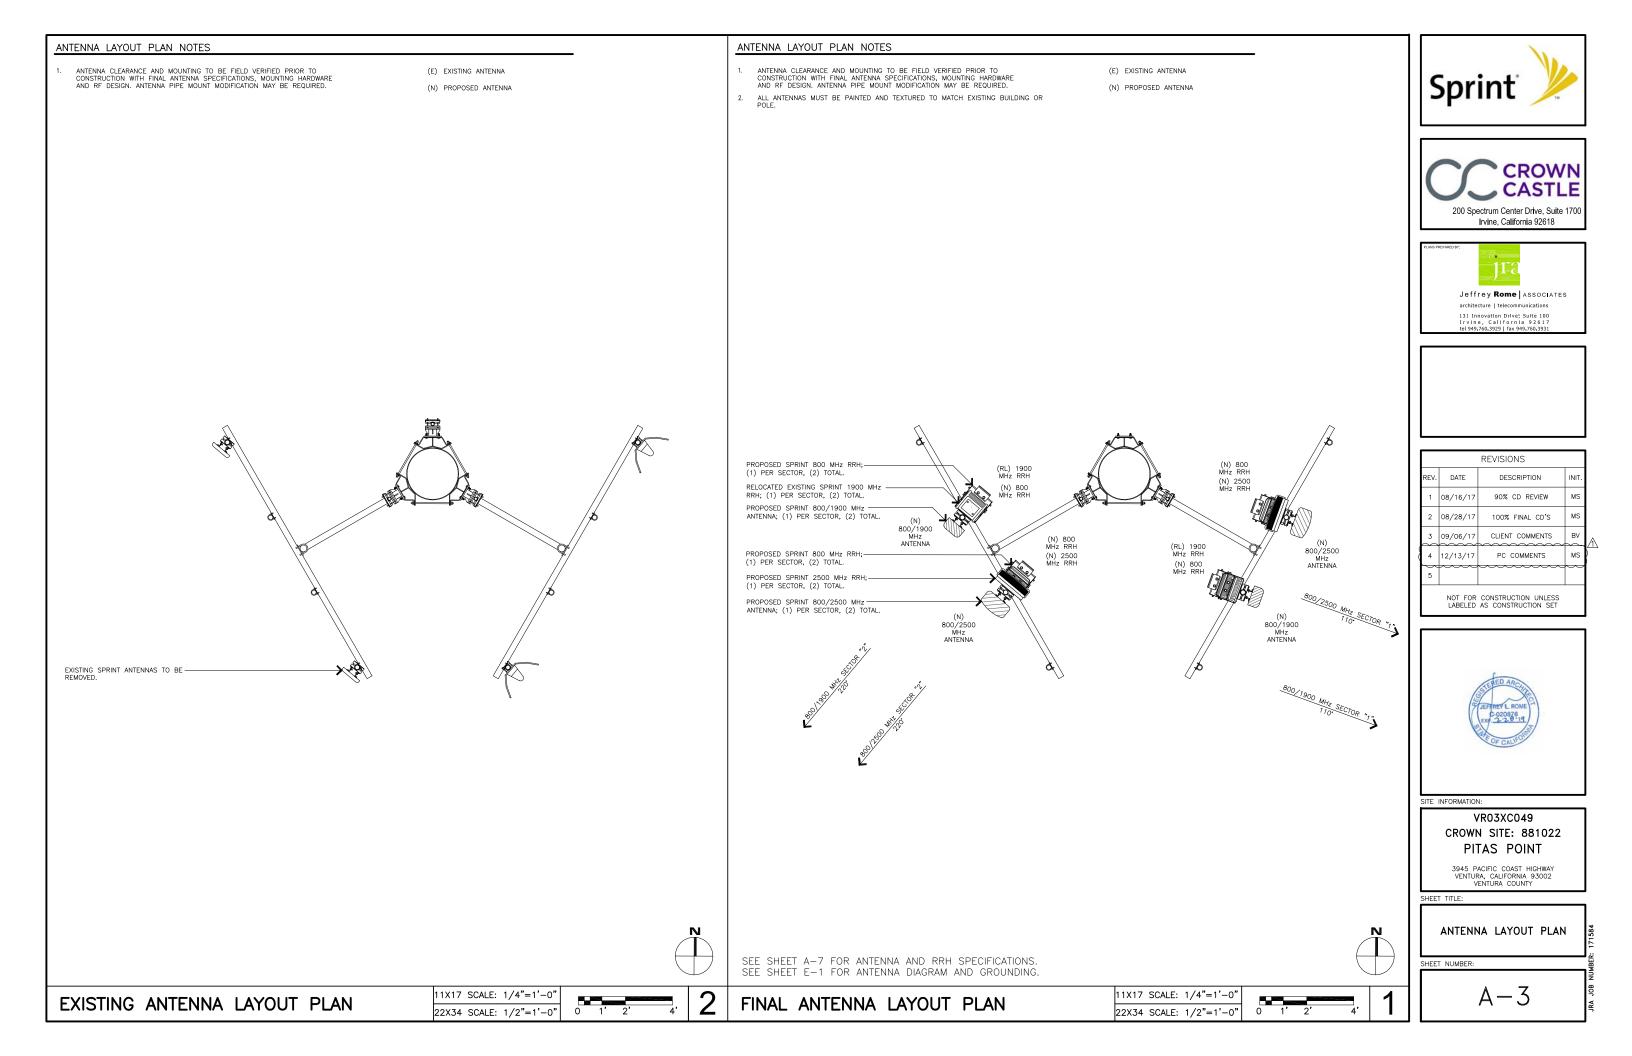


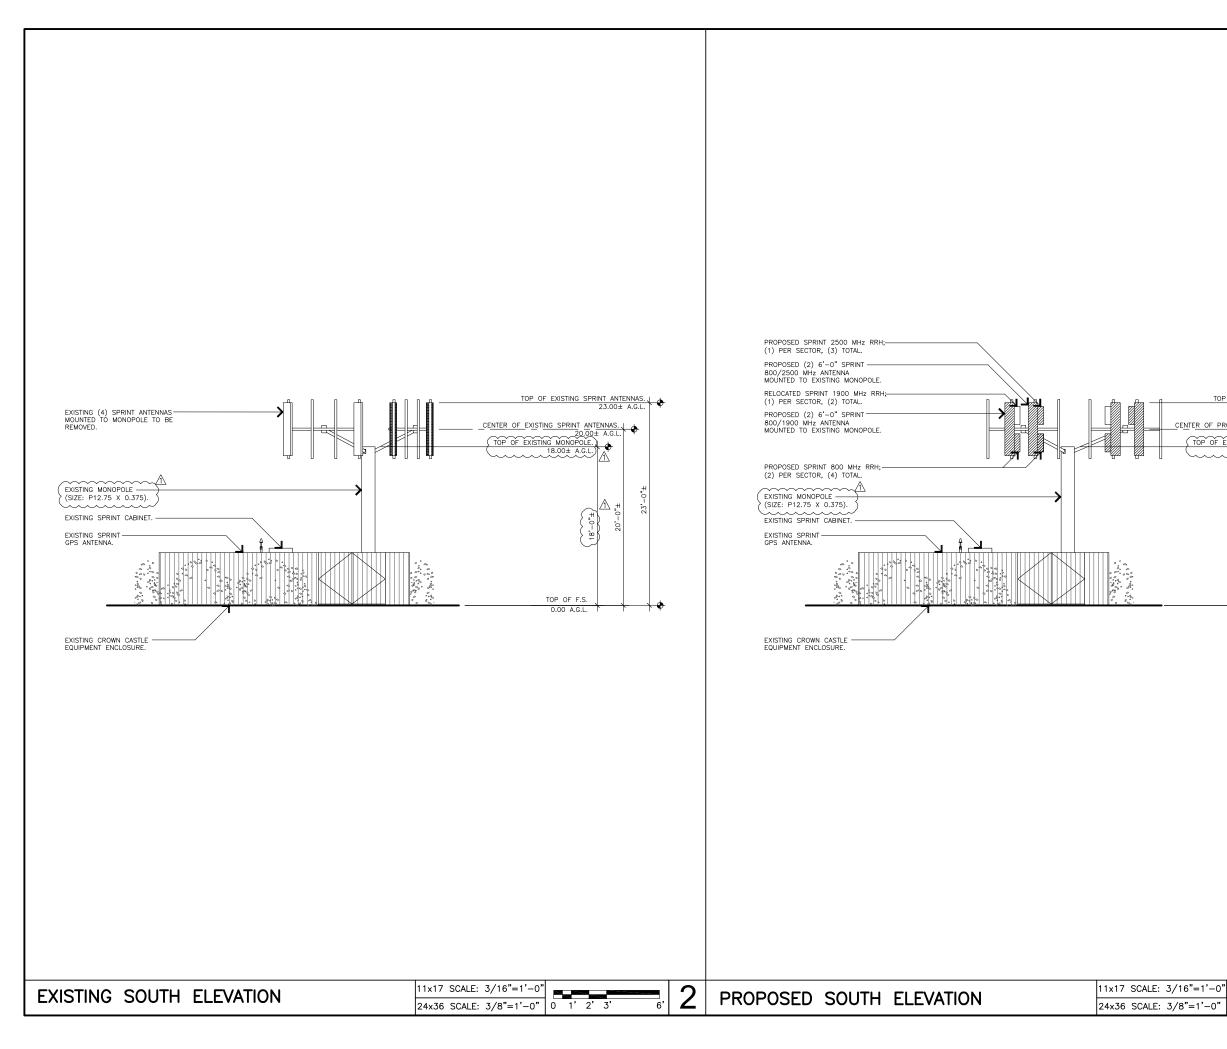

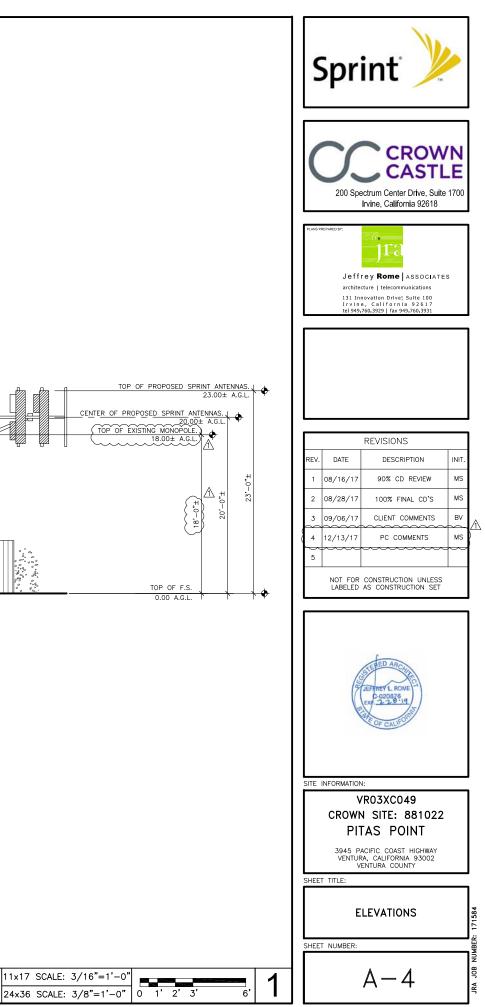

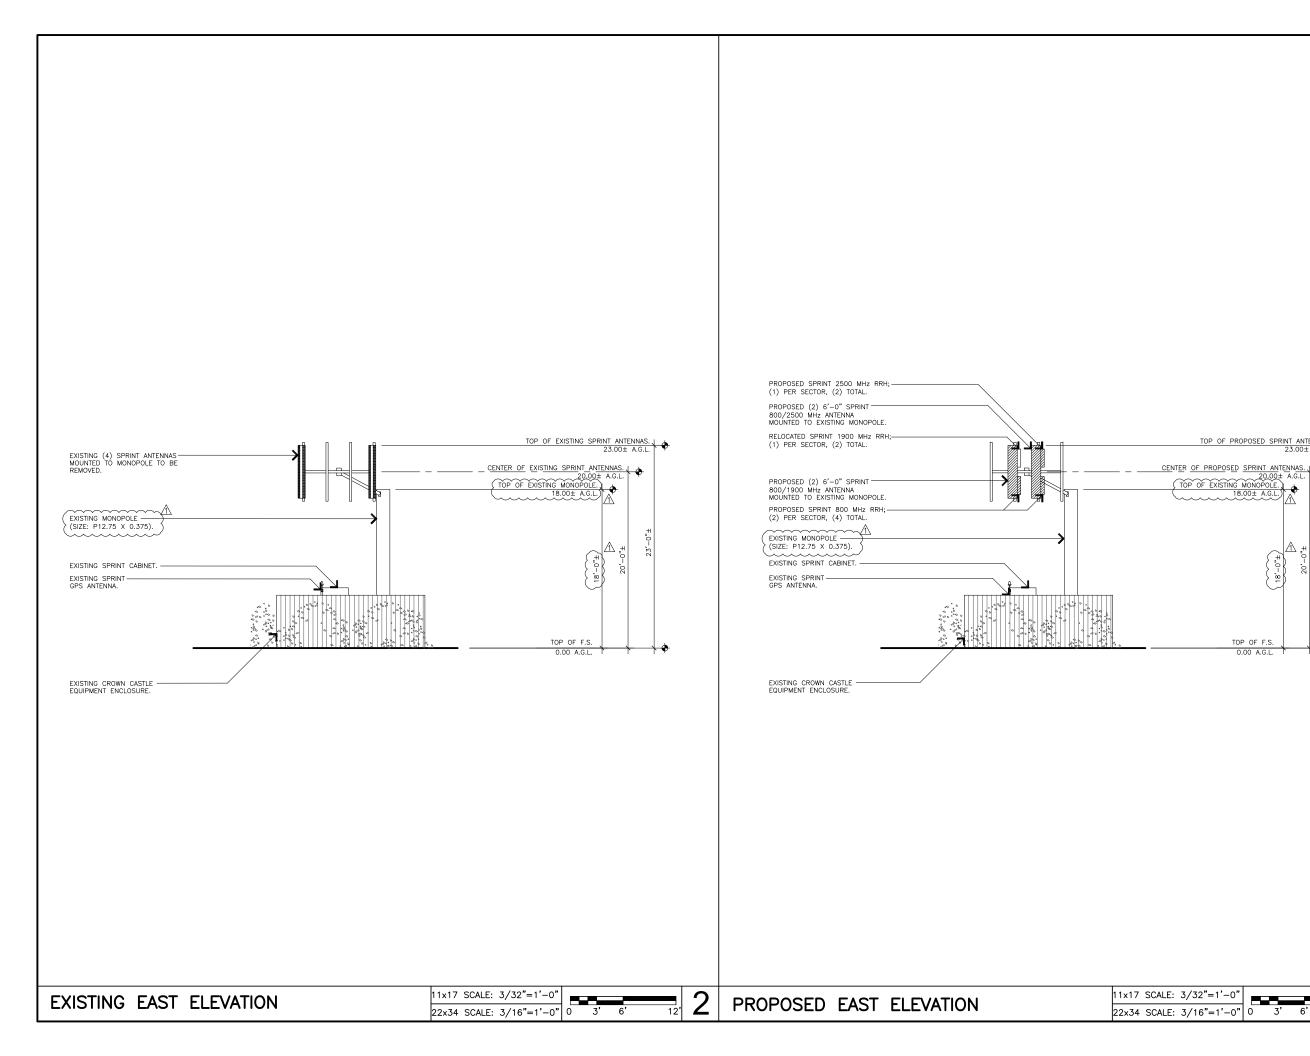

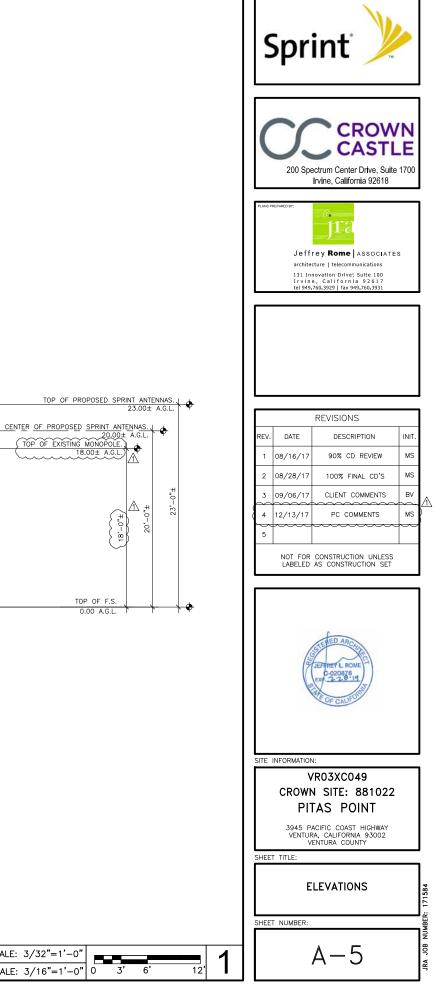

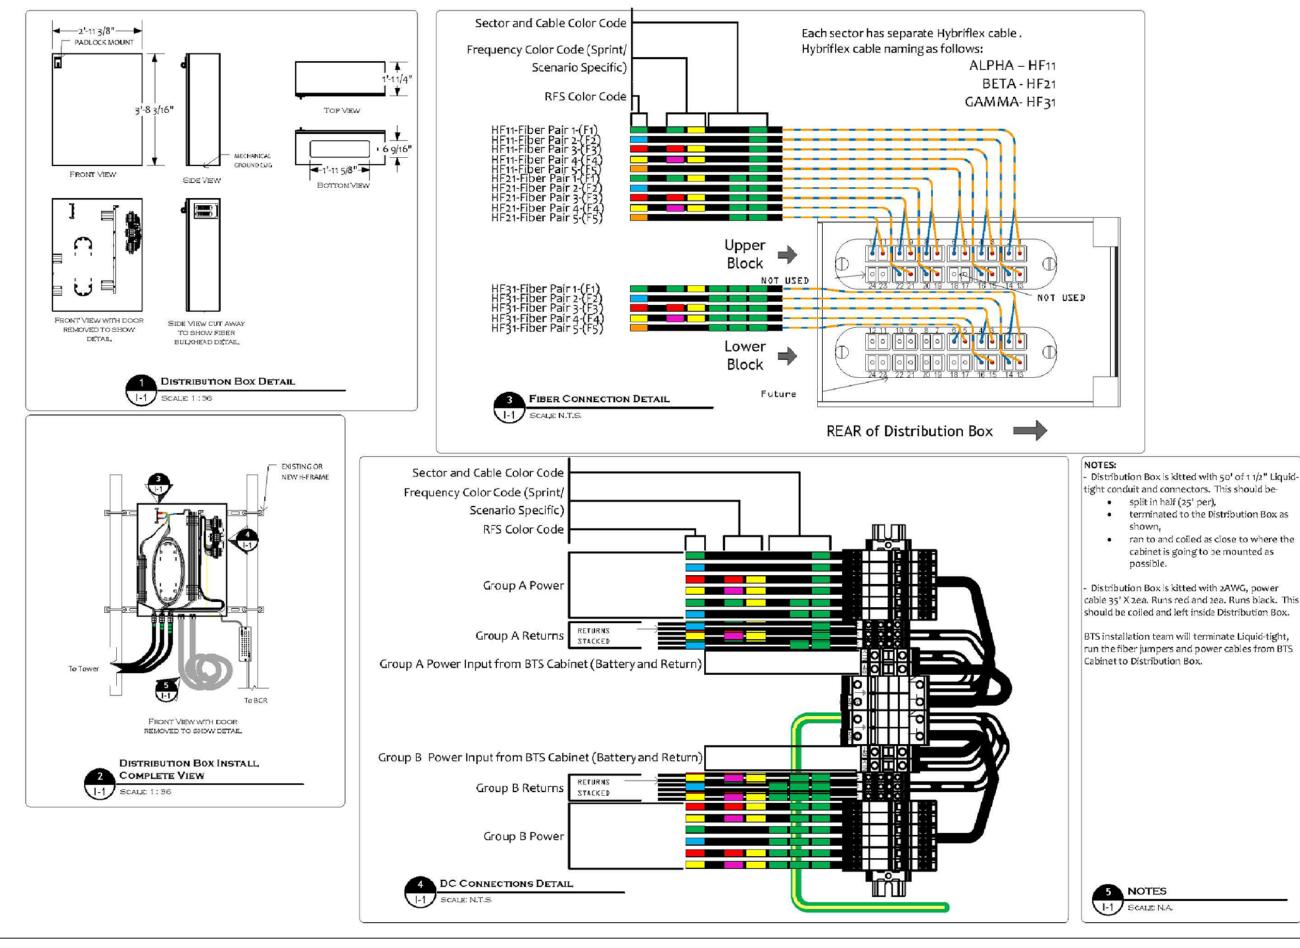

JUNCTION BOX DETAIL

it and connectors. This should be-		3	09/06/17	CLIENT COMMENTS	
plit in half (25' per), rerminated to the Distribution Box as		4	12/13/17	PC COMMENTS	Γ
shown,		5			
ran to and coiled as close to where the rabinet is going to be mounted as possible.				CONSTRUCTION UNLESS AS CONSTRUCTION SET	
on Box is kitted with 2AWG, power 2ea. Runs red and 2ea. Runs black. This oiled and left inside Distribution Box. tion team will terminate Liquid-tight, er jumpers and power cables from BTS Distribution Box.			120 S	JEFREY L ROME DEPREY L ROME ER 2.2.2.9 19 DF CALIFORN	
		SITE	INFORMATION	۷:	-
			CROWI PI ³⁹⁴⁵ P. VENTUF	VR03XC049 N SITE: 881022 TAS POINT ACIFIC COAST HIGHWAY RA, CALIFORNIA 93002 ENTURA COUNTY	
		SHEE	T TITLE:		
NOTES			JUNCTIO	ON BOX DETAIL	
)	SHEE	T NUMBER:		_
				A-6	



Sprint


200 Spectrum Center Drive, Suite 1700 Irvine, California 92618



Jeffrey Rome ASSOCIATES architecture | telecom 131 Innovation Drive, Suite 100 Irvine, California 92617 tel 949.760.3929 | fax 949.760.3931

		REVISIONS		
REV.	DATE	DESCRIPTION	INIT.	
1	08/16/17	90% CD REVIEW	MS	
2	08/28/17	100% FINAL CD'S	MS	
3	09/06/17	CLIENT COMMENTS	BV	A
4	12/13/17	PC COMMENTS	MS	
5			\sim	
		CONSTRUCTION UNLESS		



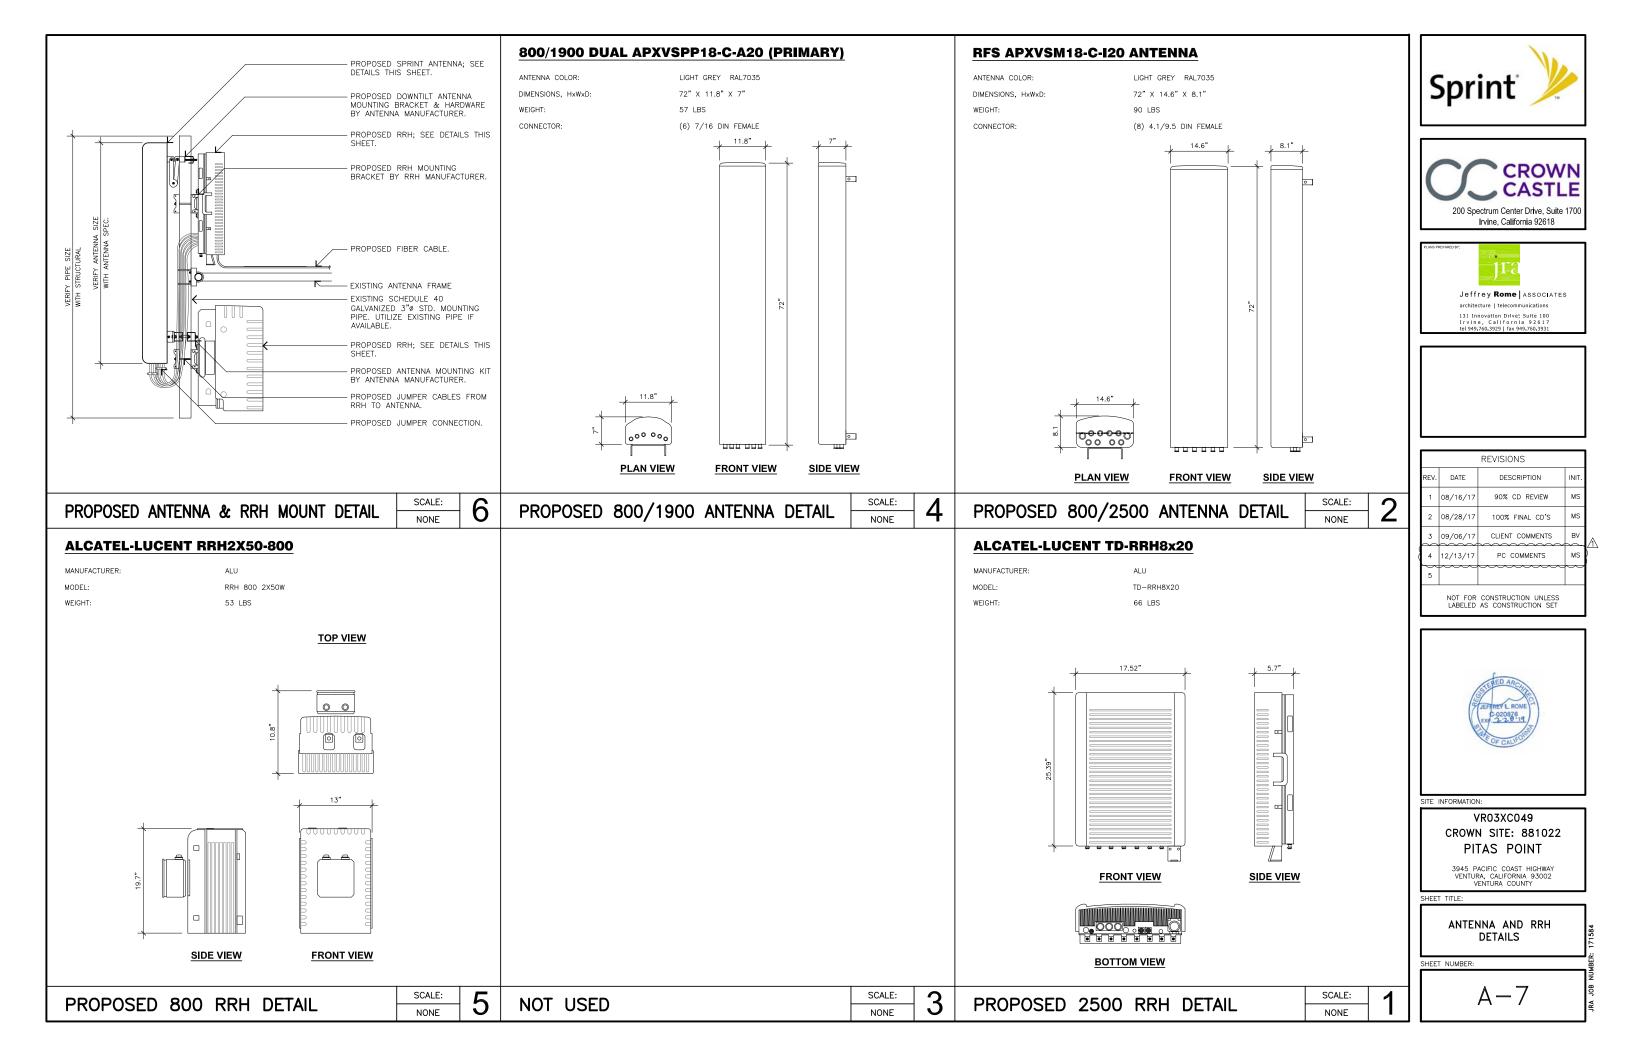

<section-header><section-header><section-header><text><list-item><list-item><list-item><section-header><section-header><list-item><list-item><list-item><list-item><list-item><list-item></list-item></list-item></list-item></list-item></list-item></list-item></section-header></section-header></list-item></list-item></list-item></text></section-header></section-header></section-header>	IYBRIFLEX™ RRH Fiber Only Cabling Solutio	n, 0x18, Riser, 5/8", Mult	i-Mode Fiber		
<text><text><section-header><section-header><section-header><section-header><list-item><list-item><list-item><list-item></list-item></list-item></list-item></list-item></section-header></section-header></section-header></section-header></text></text>	Product Description				
<text><section-header><section-header><section-header><list-item><section-header><section-header><section-header></section-header></section-header></section-header></list-item></section-header></section-header></section-header></text>	RFS' HYBRIFLEX Remote Radio Head (RRH) hybrid feeder optical fiber and DC power for RRHs in a single lightweig	ht aluminum corrugated			
<list-item><list-item><list-item><list-item><list-item><list-item><list-item><list-item><list-item><list-item><list-item><list-item></list-item></list-item></list-item></list-item></list-item></list-item></list-item></list-item></list-item></list-item></list-item></list-item>	It was developed to reduce installation complexity and co allows mobile operators deploying an RRH architecture to installation process and eliminate the need for and cost o combines optical fiber (multi-mode or single-mode) and p	sts at Cellular sites. HYBRIFLEX standardize the RRH of cable grounding. HYBRIFLEX sower in a single corrugated			
<list-item><list-item><list-item><list-item><list-item><list-item><list-item><list-item><list-item><list-item><list-item></list-item></list-item></list-item></list-item></list-item></list-item></list-item></list-item></list-item></list-item></list-item>	Features/Benefits		*		
Figure 1: HYBRIFLEX Series Suncture Outer Conductor Amon: Corrugated Aluminum m(m) 18.5 (0,73) Sandard (mets or exceeds) ULTSEG Mpc UL Usted Methonical Properties Methonical Properties Methonical Properties Multi-multi Bending Badus, Researched Bending mm (m) 10.











RFS The Clear Choice* HB058-M12-xxxF Rev: P1 Print Date: 1.11.2013					
Environment Installation Temperature [°C (°F)] -20 to +65 (-4 to +149) Operation Temperature [°C (°F)] -40 to +65 (-40 to +149) Storage Temperature [°C (°F)] -40 to +70 (-40 to +158)	Insertion Loss @ wavelength 1310nm	dB/km		1666)	
Installation Temperature Image: C (P) -20 to +55 (4 to +149) Operation Temperature PC (P) -40 to +65 (40 to +149) Storage Temperature PC (P) -40 to +70 (-40 to +158) * This data is provisional and subject to change. * This data is provisional and subject to change. RFS The Clear Choice* HB058-M12-xxxF Rev: P1 Print Date: 1.11.2013					
Storage Temperature (°C (°F)) -40 to +70 (-40 to +158) * This data is provisional and subject to change. RFS The Clear Choice® HB058-M12-xxxF Rev: P1 Print Date: 1.11.2013	Installation Temperature				
RFS The Clear Choice® HB058-M12-xxxF Rev: P1 Print Date: 1.11.2013					
RFS The Clear Choice® HB058-M12-xxxF Rev: P1 Print Date: 1.11.2013					
ase visit us on the internet at http://www.riswohu.com	<u> </u>		Paur D1	Drine Dr. 41 1 1 2012	
	RFS The Clear Choice®	HB058-M12-xxxF	Rev: P1		

